

Valley Ridge Industrial Park_Markup Summary

DRussell (5)

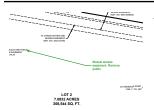


Author: DRussell

Mutual access easement. Remove public.

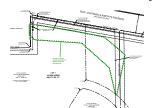


Author: DRussell

Include a mutual access easement as shown on the 1st concept plan.

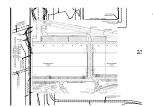

Author: DRussell

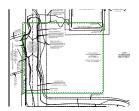

Author: DRussell



Author: DRussell


Include any utility or private drainage easements that could be crossing lot lines.

Jon Beckham (11)



Author: Jon Beckham

An access easement is required to the adjacent property [Section VI.8.1.c.2.e.2)(a)]

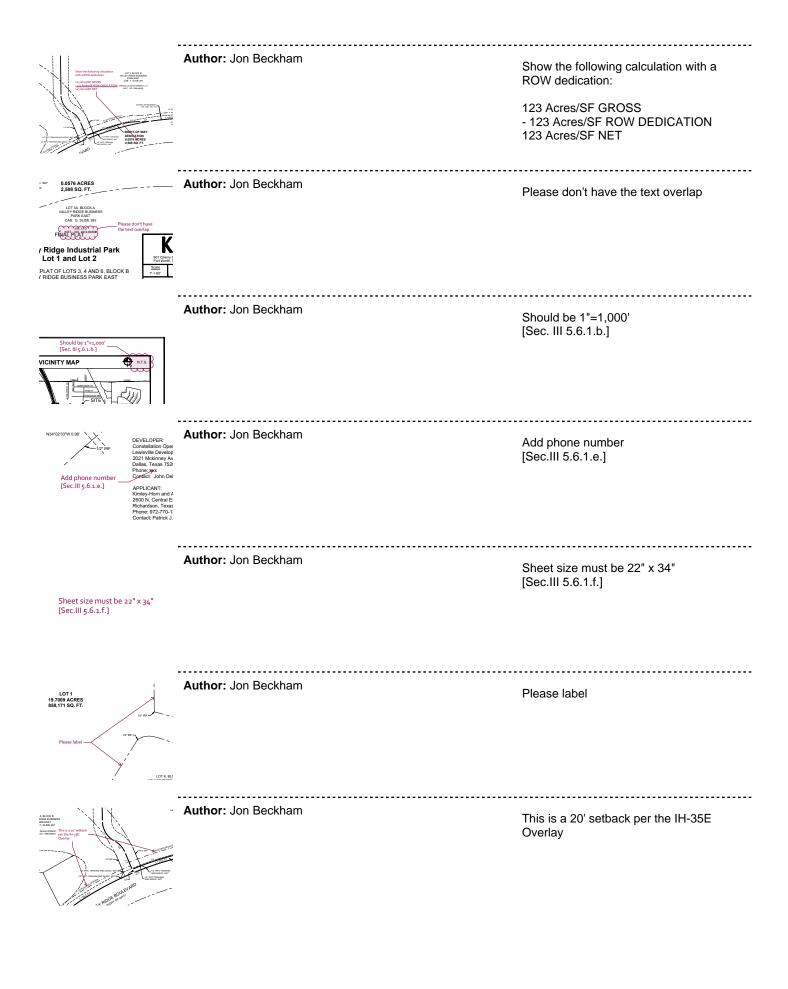

List the zoning of adjacent lots [Sec.III 5.6.2.d.]		Author: Jon Beckham	List the zoning of adjacent lots [Sec.III 5.6.2.d.]
he une person ed the same for Karen Locke	MaryEller Planning City of Le	Author: Jon Beckham	Karen Locke
Section 1 and 1 an	- Visita	Author: Jon Beckham	Please remove