
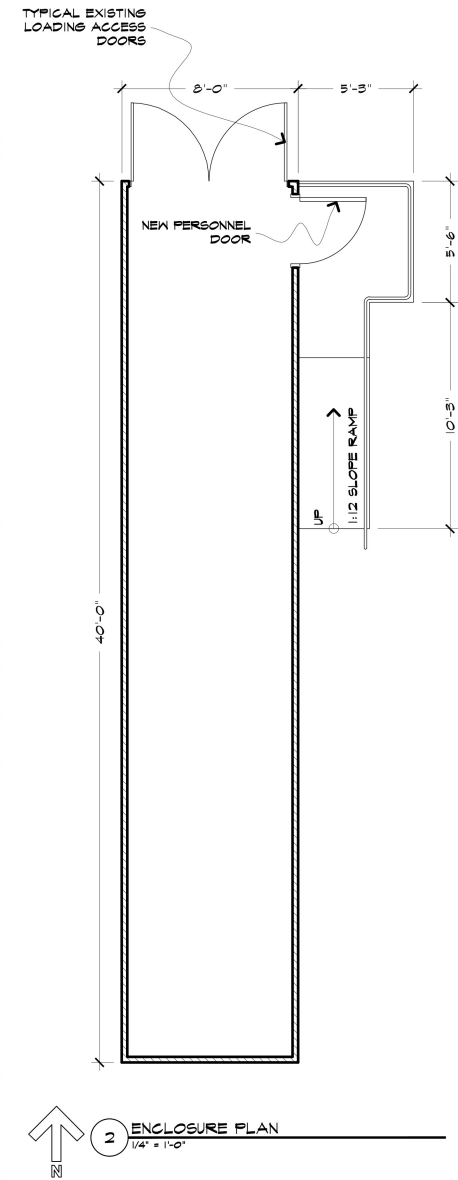


3 ENLARGED TYPICAL AS BUILT STORAGE ENCLOSURE ELEVATIONS
1/4" = 1'-0"

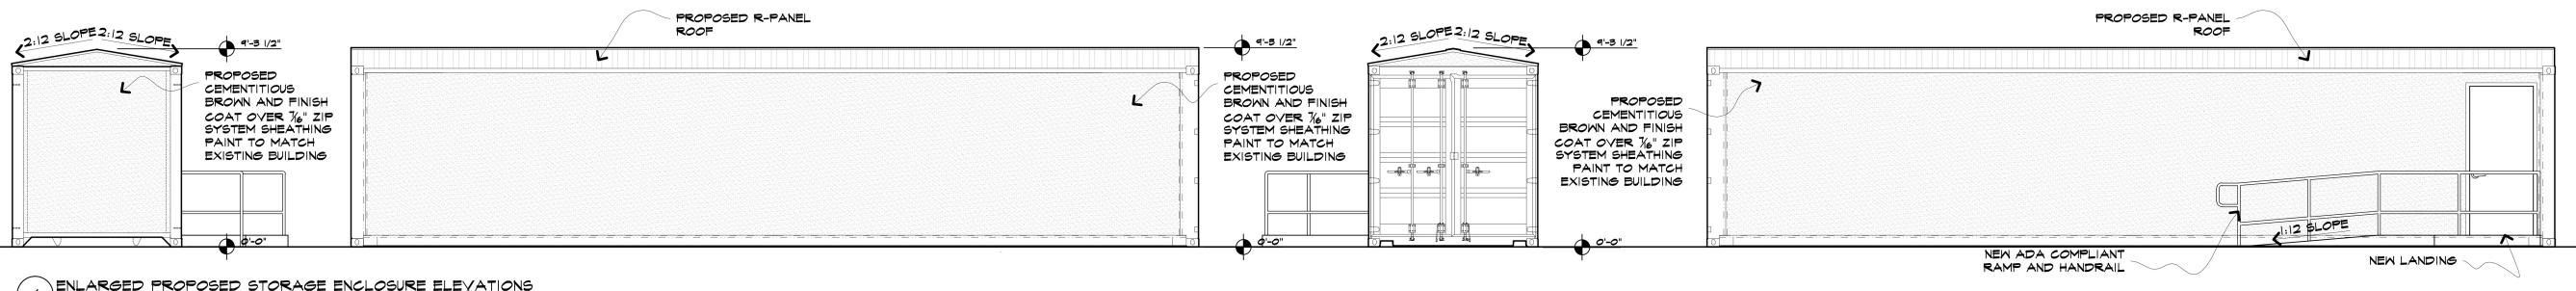

4 ENLARGED PROPOSED STORAGE ENCLOSURE ELEVATIONS
1/4" = 1'-0"

CADLIB
DESIGN / BUILD
2707 S Cooper St., Suite 109
ARLINGTON, TEXAS 76015
VOICE - 682.274.4903
WWW.CADLIB.COM

RELEASED FOR
REGULATORY USE
April 7th 2025

DESIGN AND DRAWINGS ARE SOLE
COPYRIGHTED PROPERTY OF
© CADLIB 2025

ALTERNATIVE STANDARDS
APPLICATION EXHIBIT
STARSHIP BAGELS
ANCILLARY STORAGE ENCLOSURE
1108 W MAIN ST.
LEWISVILLE, TX 75067
1108 W. MAIN ST., LEWISVILLE TX 75067

CADLIB DESIGN / BUILD PROJECT #
50313

DATE ISSUED
April 7th, 2025

REVISIONS		
No.	DATE	DESCRIPTION

SHEET TITLE
SITE PLAN AND
ELEVATIONS

SHEET NUMBER
AE201