
1st - Vista Ridge Village Addn_Markup Summary

Lauren Cook (15) Author: Lauren Cook Vicinity Maps should be 1in to 1000ft Author: Lauren Cook New Chairperson, name should be Karen Locke Author: Lauren Cook This part appears to be a part of parcel to the north that is owned by the City. Author: Lauren Cook AB. I, PG. 3 85"18'24"E 1.014.15 Author: Lauren Cook ZUNL ZONEX Line Table Length Direction Author: Lauren Cook STATE COUNT KNOWI 45) BEING, B, Vista in Speci describe (P.R.D.C.T.) BEGINN Cabinet VARIABLE WUTH DRAINAGE EASEMENT (CAB.I. PG. 345) Author: Lauren Cook

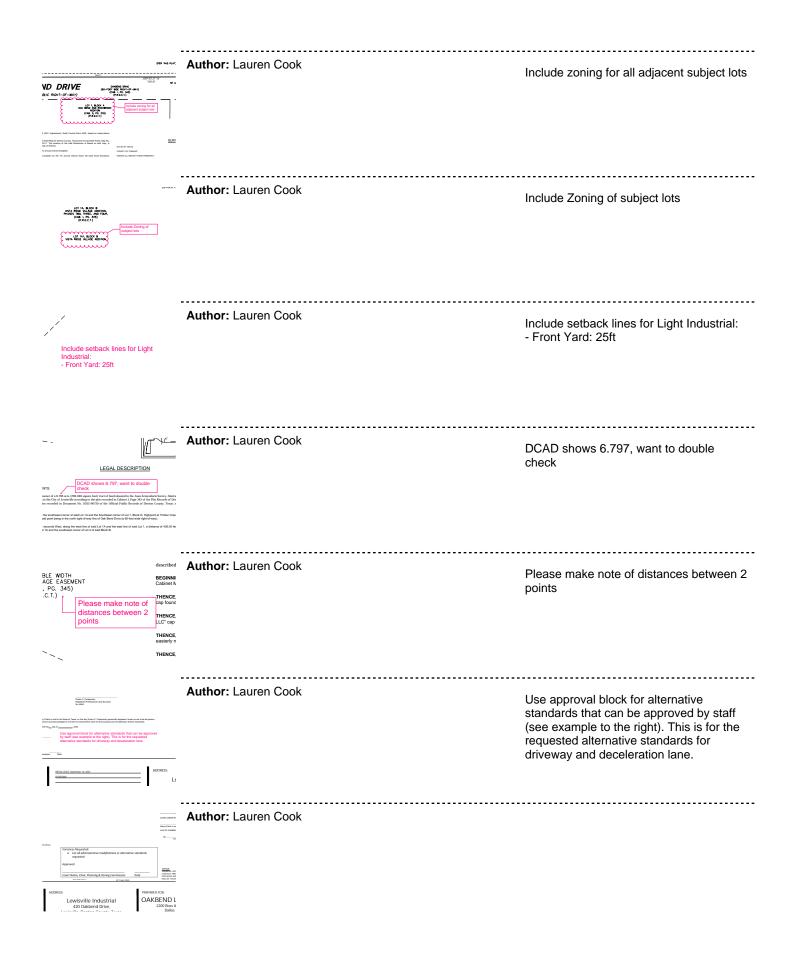

en e	Author: Lauren Cook	
<text><text><text><text><text></text></text></text></text></text>	Author: nrezaei	R.O.W. dedication square footage and acreage must be listed on the plan.
As Trans Candidate Ryten of 100 (2011 signature); buth Canto Zine 202, based on data take the of LOBOSCOM.	Author: nrezaei	Add: It shall be the property owner's responsibility to maintain the floodway and drainage easement
Zone "X" - Zone "A" - Zone AE not A <u>Owner's Certification</u> Now therefore, know all persons by th	Author: nrezaei	Zone AE not A